

NOTE:
ENTIRE EXISTING ROOF COVER TO BE REMOVED AND REPLACED TO MATCH NEW.


AUDITORIUM CEILING DRYWALL SURFACES TO REMAIN UNTOUCHED U.N.O.

AUDITORIUM MECHANICAL SUPPLY DUCTING & DIFFUSERS TO REMAIN U.N.O.

ALL OTHER INT. ELECTRICAL FIXTURES, DIFFUSERS, FLEXI-DUCT, VENTS, & SOFFITS SHALL BE REMOVED U.N.O.

REMOVE EXIST. DRYWALL & INSUL. @ ALL FLAT CEILINGS- EXPOSING TRUSSES U.N.O.

NO	DATE	REVISION	BY

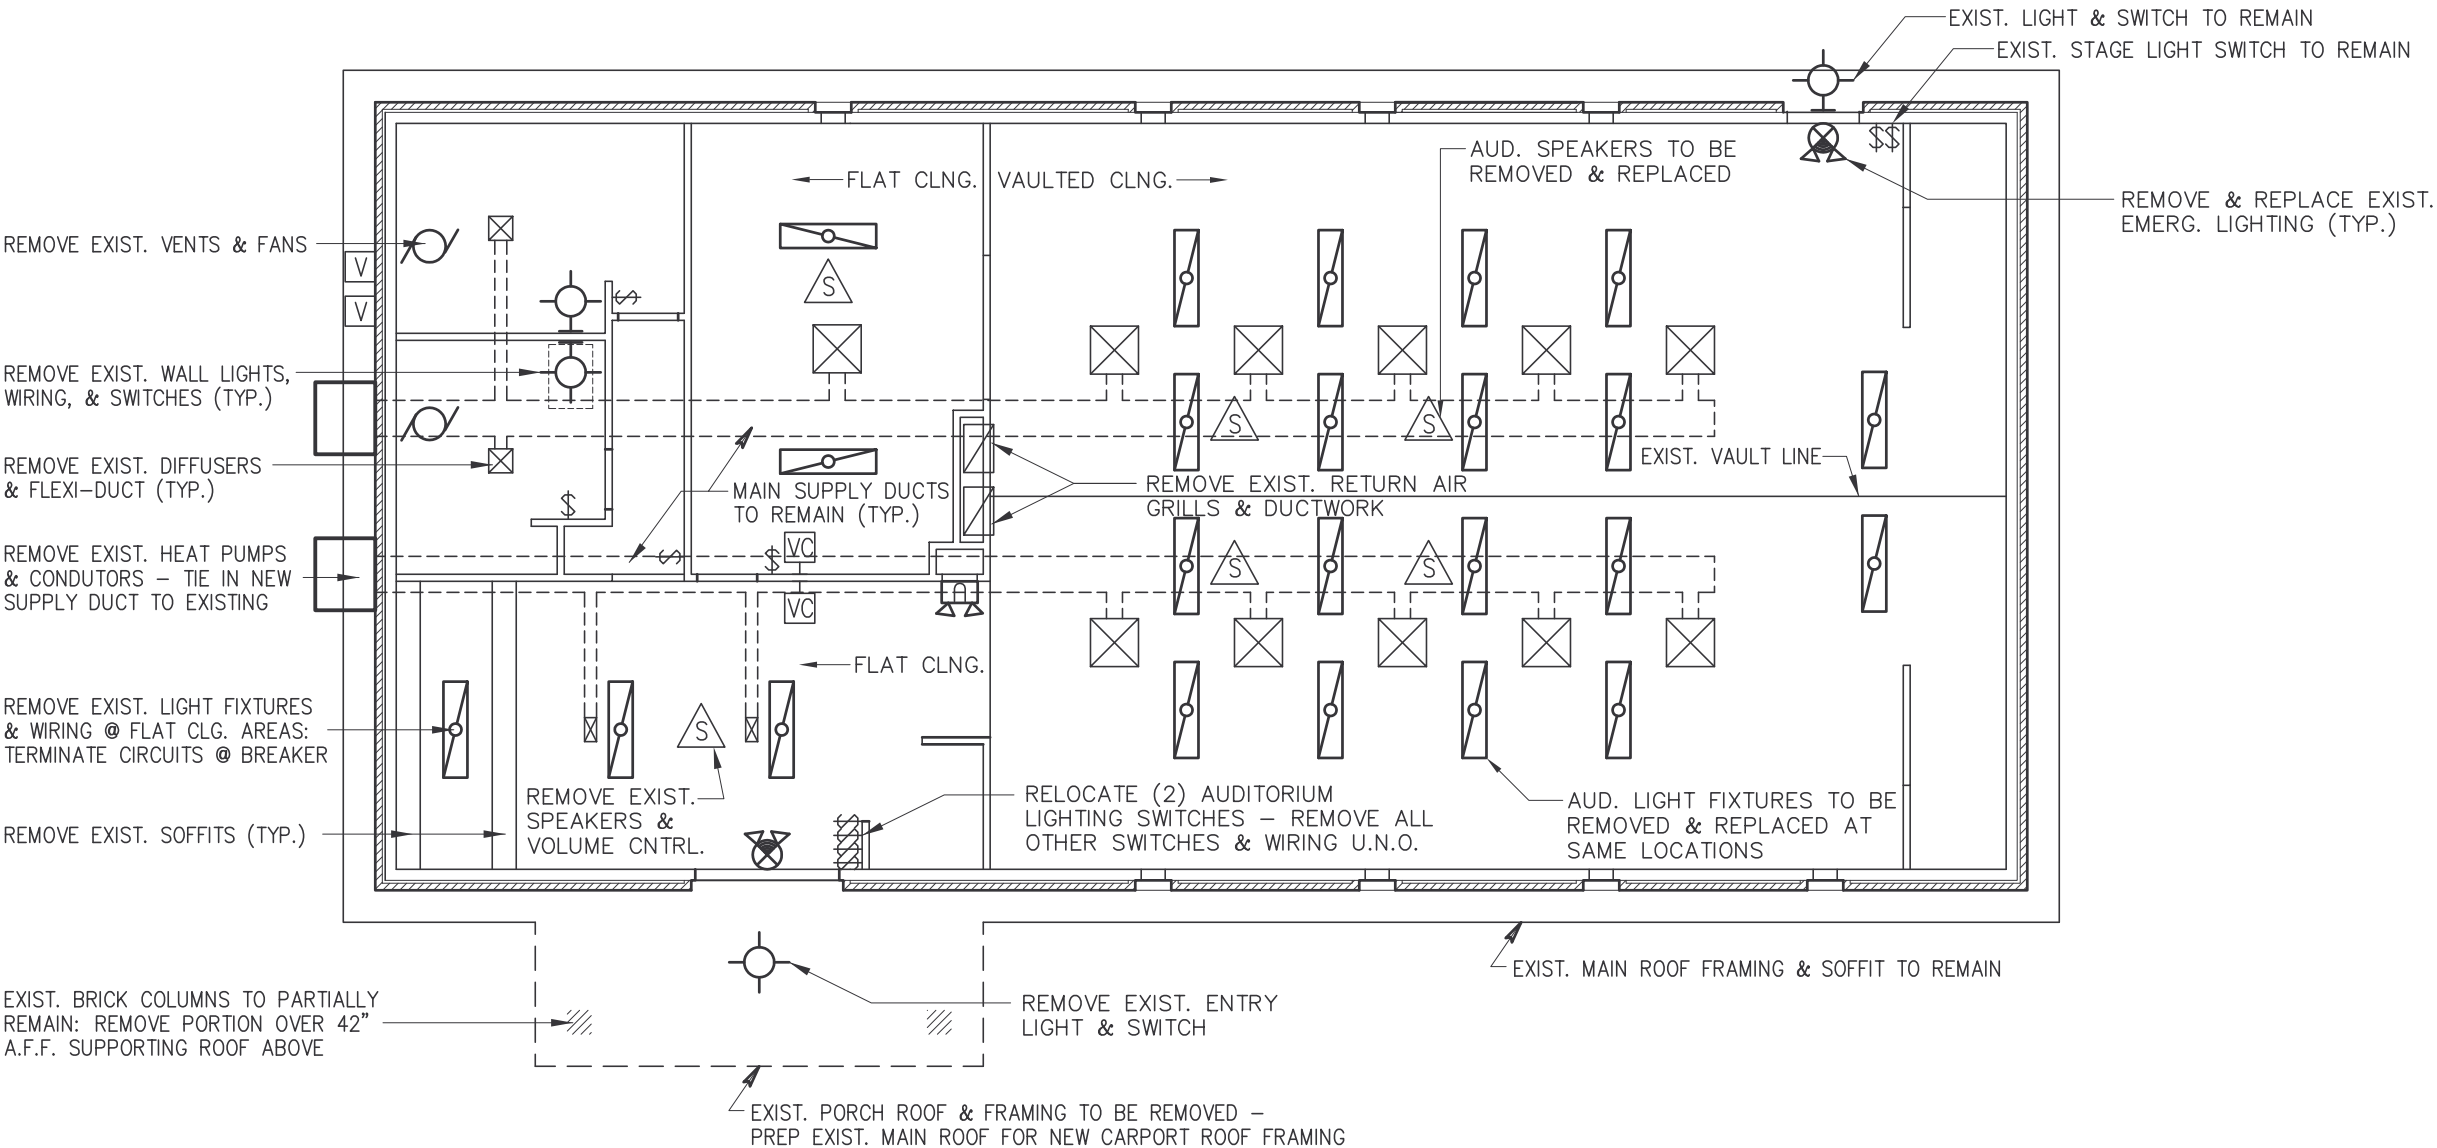

A DEMOLITION R.C.P.
A2.4 SCALE: 1/8"=1'-0"

APPROVED FOR CONSTRUCTION

SHEET TITLE
AS BUILT - DEMOLITION
REFLECTED CEILING PLAN

PROJECT TITLE
KINGDOM HALL OF JEHOVAH'S WITNESSES
LIBERTY CONGREGATION ADDITION & REMODEL PROJECT
119 HWY 49, LIBERTY, KY USA

DWN BY: DSA CKD BY: DSA
SCALE: 1/8"=1'-0"
DATE: 4/9/2007
CAD #: LBRT-A24
SHEET No.
A2.4